

LABOR AND MATERIALS


Copper } Connection _____ \$	
Lead } _____ \$	
Curb } Cock _____ in. \$	
} Valve _____ in. \$	
} T. S. & V. _____ in. \$	
Service box } Short 3 1/2 x 4 1/2 } _____ \$	
Old returned } Long 4 1/2 x 5 1/2 } _____ \$	
23 Ft. 3/4 in. } Copper } Pipe at _____ \$	
} G.I. } _____ \$	
} C.I. } _____ \$	
Nipples _____ in. at _____ \$	
Bushings _____ to _____ in. at _____ \$	
Red'g } Coupl'gs _____ to _____ in. at _____ \$	
Inc'g } _____ in. at _____ \$	
Union _____ in. at _____ \$	
Meter _____ in. at _____ \$	
_____ \$	
Compound Joints at _____ \$	
Maintenance Foreman _____ \$	
Hrs. Water Maint. Man—1 at _____ \$	
Hrs. Water Maint. Man—2 at _____ \$	
Hrs. Garage Foreman _____ at _____ \$	
Hrs. Labor— _____ at _____ \$	
Hrs. Compressor at _____ \$	
_____ \$	
Trucking _____ \$	
Pav't Patch _____ \$	
_____ \$	
_____ \$	
Rd
St.
Pl.
Ave. No. 24

Wendy Hill

Name of Owner
Scoville

Labor and Mat'l. Report Dec 1987

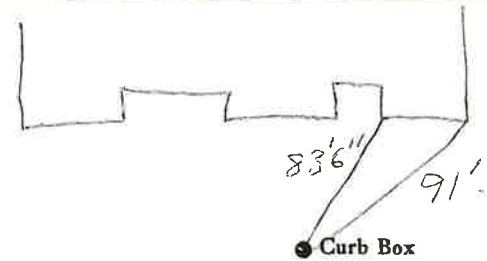

Main Elev. of Main at tap _____

Gate at • Gate at •

23' to main

• Curb Box

TAX ID# 303.5-2-1