

### LABOR AND MATERIALS


1	Copper Lead	Connection	3/4"		\$
1	Curb	Cock Valve T.S. & V.	3/4 in.		\$
1	Service box Old returned	Short 3 1/2 x 4 1/2 Long 4 1/2 x 5 1/2 Buff or Rdway	5x6' with 2' Exten.		\$
30	Ft. 3/4 in.	Copper G.I. G.I.	Pipe at		\$
	Nipples	in. at			\$
	Bushings	to in. at			\$
	Red'g Inc'g	Coupl'gs to in. at			\$
	Union	in. at			\$
	Meter	in. at			\$
	Lead Joints	at			\$
	Compound Joints	at			\$
	Maintenance Foreman				\$
	Hrs. Water Maint. Man-1	at			\$
	Hrs. Water Maint. Man-2	at			\$
	Hrs. Garage Foreman	at			\$
	Hrs. Labor	at			\$
	Hrs. Compressor	at			\$
	Compensation Ins.	at \$ per C			\$
	Trucking				\$
	Pav't Patch				\$
	Tap by Gifford & Co.				\$
	6-1-64				\$
	O'head				\$

Rd.  
~~St.~~  
~~Pl.~~  
Ave. No. 25

Windy Hill

Name of Owner John Wheeler.  
Now Hertz Snow-Billy

Labor and Mat'l. Report June 1 1964

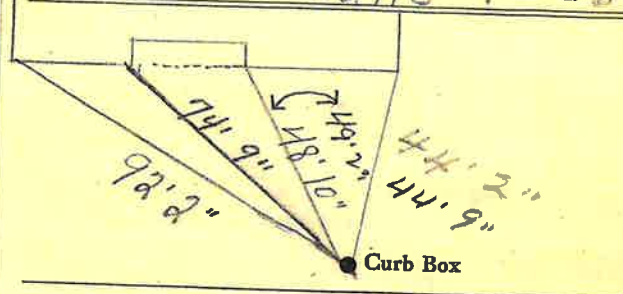

6" Main      Elev. of Main at tap 5'

Gate at ● TAX ID # 303.98-24      ● Gate at

30' to main

USE      ● Curb Box

Long Yellow Tee  
Wrench To shut off  
& Turn on.

LSM-80-3-10-61 Located and Measured in Curb box 3-9-66.  
by Gifford & Co.