

LABOR AND MATERIALS


Copper	} Connection _____	\$ _____	
Lead			
Curb	} _____ in. _____	\$ _____	
			Cook Valve
			T. S. & V.
Service box	} { Short 3½ x 4½ Long 4½ x 5½ Buff or Rdway } _____	\$ _____	
Old returned			
Ft. _____ in. _____	} { Copper G.I. C.I. } Pipe at _____	\$ _____	
Nipples _____ in. at _____			
Bushings _____ to _____ in. at _____			
Red'g } Inc'g }	} Coupl'gs _____ to _____ in. at _____	\$ _____	
Union _____ in. at _____			
Meter _____ in. at _____	\$ _____		
Lead Joints at _____	\$ _____		
Compound Joints at _____	\$ _____		
Maintenance Foreman _____	\$ _____		
Hrs. Water Maint. Man—1 at _____	\$ _____		
Hrs. Water Maint. Man—2 at _____	\$ _____		
Hrs. Garage Foreman _____ at _____	\$ _____		
Hrs. Labor— _____ at _____	\$ _____		
Hrs. Compressor at _____	\$ _____		
Compensation Ins. at \$ _____ per C	\$ _____		
Trucking _____	\$ _____		
Pav't Patch _____	\$ _____		
_____	\$ _____		
_____	\$ _____		
_____	\$ _____		
O'head _____	\$ _____		
_____	\$ _____		

Red
 St.
 Pl.
 Ave. No. 26

Windy Hill

Name of Owner _____
Hatch

Labor and Mat'l. Report 19 86

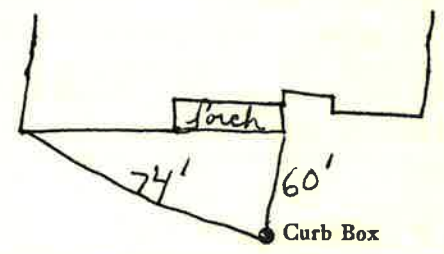

Main Elev. of Main at tap _____

Gate at • • Gate at
TAX ID# 303.5-2-2

● Curb Box