


LABOR AND MATERIALS

1	Copper	Connection	3/4"	\$
1	Curb	Cock Valve T.S. & V.	3/4 in. (MARK II ORISSMU)	\$
1	Service box	Short 3 1/2 x 4 1/2		
	Old returned	Long 4 1/2 x 5 1/2		
		Buff or Rdway		\$
29	Ft. 3/4 in.	Copper	Pipe at	\$
		Gal.		
	Nipples	in. at		\$
	Bushings	to in. at		\$
	Red'g			
	Inc'g	Coupl'gs to in. at		\$
	Union	in. at		\$
	Meter	in. at		\$
	Lead Joints	at		\$
	Compound Joints	at		\$
	Maintenance Foreman			\$
	Hrs. Water Maint. Man-1	at		\$
	Hrs. Water Maint. Man-2	at		\$
	Hrs. Garage Foreman	at		\$
	Hrs. Labor	at		\$
	Hrs. Compressor	at		\$
	Compensation Ins. at \$	per C		\$
	Trucking			\$
	Pav't Patch			\$
	Tap made by Deck			\$
	O'head	JAN 3-1973		\$

City
P:
Windy Hill Rd. Ave. No. 29
Name of Owner
Edward Nadeau

Labor and Mat'l. Report JAN 3 1973

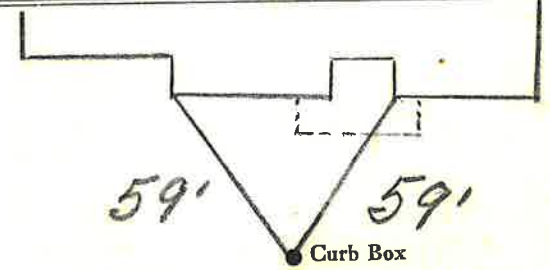

6" Main Elev. of Main at tap 5 1/2"
Gate at • Gate at
29' to main
• Curb Box

TAX ID # 303.9-8-22