


LABOR AND MATERIALS

1 Copper Lead	Connection	3/4" CORD STOPS	\$
1 Curb	Cock Valve T.S. & V.	3/4" in.	\$
1 Service box Old returned	Short 3 1/2 x 4 1/2 Long 4 1/2 x 5 1/2 Buff or Rdway		\$
33 Ft. 3/4 in.	Copper G.I. G.I.	Pipe at	\$
Nipples	in. at		\$
Bushings	to in. at		\$
1 Red'g Inc'g	Coupl'gs	3/4" to in. at	\$
Union	in. at		\$
Meter	in. at		\$
Lead Joints	at		\$
Compound Joints	at		\$
Maintenance Foreman			\$
Hrs. Water Maint. Man-1	at		\$
Hrs. Water Maint. Man-2	at		\$
Hrs. Garage Foreman	at		\$
Hrs. Labor	at		\$
Hrs. Compressor	at		\$
Compensation Ins. at \$	per C		\$
Trucking			\$
Pav't Patch			\$
TAPED BY LARCAU & CO			
O'head			\$

St. Pl. Ave. No. 31  
 WINDY HILL RD

Name of Owner  
 ROBT J. MCCARTHY

Labor and Mat'l. Report NOV-19 1969

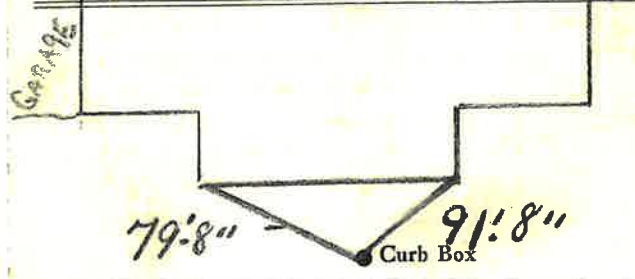

6" Main Elev. of Main at tap 6 1/2'  
 Gate at • Gate at

33' to MAIN

• Curb Box

TAX ID # 303.9-8-21