

LABOR AND MATERIALS

1	Copper Lead	Connection	3/4"	\$
1	Curb	Cock Valve T.S. & V.	3/4" in. Oriseal	\$
1	Service box Old returned	Short 3 1/2 x 4 1/2 Long 4 1/2 x 5 1/2 Buff or Rdway		\$
12	Ft.	3/4" in. { Copper G.I. C.I. } Pipe at		\$
	Nipples	in. at		\$
	Bushings	to in. at		\$
	Red'g Inc'g	Coupl'gs. to in. at		\$
	Union	in. at		\$
	Meter	in. at		\$
	Lead Joints at			\$
	Compound Joints at			\$
	Maintenance Foreman			\$
	Hrs. Water Maint. Man-1 at			\$
	Hrs. Water Maint. Man-2 at			\$
	Hrs. Garage Foreman at			\$
	Hrs. Labor at			\$
	Hrs. Compressor at			\$
	Compensation Ins. at \$	per C		\$
	Trucking			\$
	Pav't Patch			\$
	Tap by Gifford & Co.			\$
				\$
				\$
	O'head			\$
				\$


8-20-65

Rd  
St  
Pl  
Ave. No. 32

Windyhill

Name of Owner  
Harold Yanklowitz

Labor and Mat'l. Report Aug. 20 1965

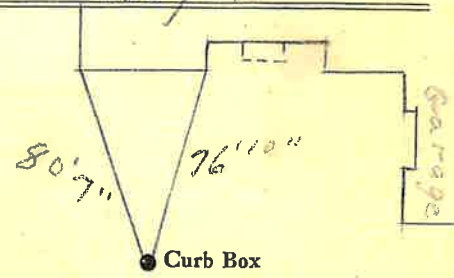

Ch. M.T.  
6" Main Elev. of Main at tap 5'

Gate at • Gate at

12' to main

• Curb Box

TAX ID # 303.5-2-5