


LABOR AND MATERIALS

1 Copper } Connection ^{3/4"} \$
 1 Lead }
 1 Curb } Cock } 3/4 in. Oriseal \$
 } Valve }
 } T.S. & V. }
 1 Service box } Short 3 1/2 x 4 1/2 }
 Old returned } Long 4 1/2 x 5 1/2 } \$
 } Buff or Rdway }
 12 Ft. 3/4 in. } { Copper } Pipe at \$
 } { G. I. }
 } { C. I. }
 Nipples in. at \$
 Bushings to in. at \$
 Red'g }
 Inc'g } Coupl'gs. to in. at \$
 Union in. at \$
 Meter in. at \$
 Lead Joints at \$
 Compound Joints at \$
 Maintenance Foreman \$
 Hrs. Water Maint. Man-1 at \$
 Hrs. Water Maint. Man-2 at \$
 Hrs. Garage Foreman at \$
 Hrs. Labor at \$
 Hrs. Compressor at \$
 Compensation Ins. at \$ per C \$
 Trucking \$
 Pav't Patch \$
 Tap by Gissard \$
 8-23-65. \$
 O'head \$
 \$

St. Windyhill Rd. Ave. No. 34
 Pt. 34

Name of Owner
 Albert Hessler.

Labor and Mat'l. Report Aug. 23 1965.

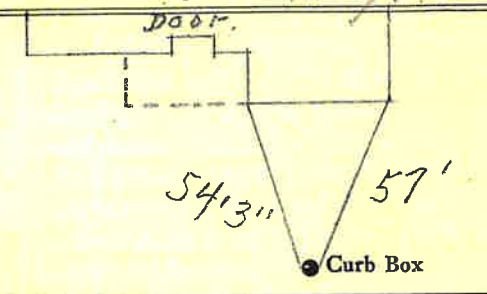

6" C.I. M.J. Main Elev. of Main at tap 5'

Gate at • Gate at •

12' to main

• Curb Box

TAX ID# 303.5-2-6