


LABOR AND MATERIALS

1	Copper Lead	Connection	3/4"	\$
1	Curb	Cock Valve T.S. & V.	3/4" in. Oriseal.	\$
1	Service box	Short 3 1/2 x 4 1/2		
	Old returned	Long 4 1/2 x 5 1/2		
		Buff or Rdway		\$
34	Ft.	Copper G.I. C.I.	3/4" in. Pipe at	\$
	Nipples	in. at		\$
	Bushings	to in. at		\$
	Red'g Inc'g	Coupl'gs to in. at		\$
	Union	in. at		\$
	Meter	in. at		\$
	Lead Joints	at		\$
	Compound Joints	at		\$
	Maintenance Foreman			\$
	Hrs. Water Maint. Man-1	at		\$
	Hrs. Water Maint. Man-2	at		\$
	Hrs. Garage Foreman	at		\$
	Hrs. Labor-	at		\$
	Hrs. Compressor	at		\$
	Compensation Ins.	at \$ per C		\$
	Trucking			\$
	Pav't Patch			\$
	Tap by Gifford + Co.			\$
	8-28-68.			\$
	O'head			\$

Rd. Windy Hill
St. _____
Pl. _____
Ave. No. 35

Name of Owner
William Chambers

Labor and Mat'l. Report Aug. 28 1968

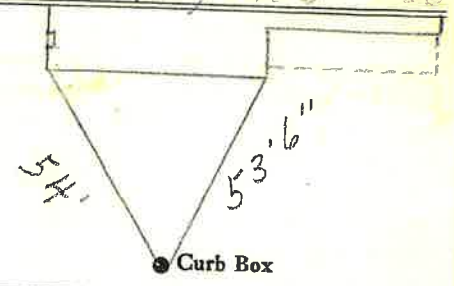

6" C.I. Main Elev. of Main at tap 6'

Gate at • Gate at

34' to main

• Curb Box

10/22
not on map