

LABOR AND MATERIALS

1 Copper Lead } Connection 3/4" \$  
 1 Curb } Cock } 3/4" in. 0-15221 \$  
 } Valve }  
 } T.S. & V. }  
 1 Service box } Short 3 1/2 x 4 1/2 }  
 Old returned } Long 4 1/2 x 5 1/2 }  
 } Buff or Rdway } \$  
 11 Ft. 3/4 in. } Copper } Pipe at \$  
 } C.I. }  
 } C.I. }  
 Nipples in. at \$  
 Bushings to in. at \$  
 Red'g }  
 Inc'g } Coupl'gs. to in. at \$  
 Union in. at \$  
 Meter in. at \$  
 Lead Joints at \$  
 Compound Joints at \$  
 Maintenance Foreman \$  
 Hrs. Water Maint. Man-1 at \$  
 Hrs. Water Maint. Man-2 at \$  
 Hrs. Garage Foreman at \$  
 Hrs. Labor at \$  
 Hrs. Compressor at \$  
 Compensation Ins. at \$ per C \$  
 Trucking \$  
 Pav't Patch \$  
Tap by Gifford & Co. \$  
11-8-65 \$  
 O'head \$  
 \$


Windy Hill

Rd.  
~~St.~~  
~~Pl.~~  
 Ave. No. 4

Name of Owner

TAX ID# 303.9.7-1

Labor and Mat'l. Report Nov. 8 1965

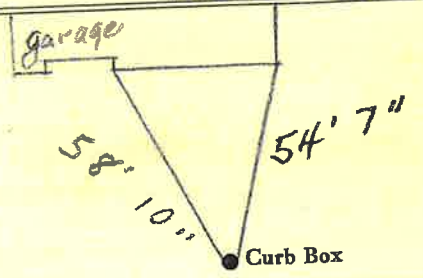

6" Main

Elev. of Main at tap 5 1/2'

Gate at •

• Gate at

11' to MAIN

• Curb Box