

LABOR AND MATERIALS


| | | | | |
|----|-----------------------------|--|-----------------|----|
| 1 | Copper Lead | Connection | 3/4" | \$ |
| 1 | Curb | Cock Valve T.S. & V. | 3/4 in. Or-seal | \$ |
| 1 | Service box Old returned | Short 3 1/2 x 4 1/2 Long 4 1/2 x 5 1/2 Buff or Rdway | | \$ |
| 37 | Ft. | 3/4 in. { Copper C.I. C.I. } | Pipe at | \$ |
| | Nipples | in. at | | \$ |
| | Bushings | to in. at | | \$ |
| | Red'g Inc'g | Coupl'gs to in. at | | \$ |
| | Union | in. at | | \$ |
| | Meter | in. at | | \$ |
| | Lead Joints | at | | \$ |
| | Compound Joints | at | | \$ |
| | Maintenance Foreman | | | \$ |
| | Hrs. Water Maint. Man-1 | at | | \$ |
| | Hrs. Water Maint. Man-2 | at | | \$ |
| | Hrs. Garage Foreman | at | | \$ |
| | Hrs. Labor | at | | \$ |
| | Hrs. Compressor | at | | \$ |
| | Compensation Ins. at \$ | per C | | \$ |
| | Trucking | | | \$ |
| | Pav't Patch | | | \$ |
| | Tap by Gifford + Co | | | \$ |
| | | 11-10-65 | | \$ |
| | O'head | | | \$ |

Rd. Windy Hill
 St. 5
 Pl. 5
 Ave. No. 5

Name of Owner John Wheeler

TAX ID # 303.9-8-34

Labor and Mat'l. Report Nov. 10 1965

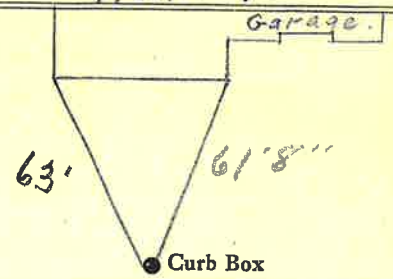

6" Main Elev. of Main at tap 5

Gate at • Gate at

37' to main

• Curb Box