

LABOR AND MATERIALS

1	Copper Lead	Connection	3/4"	\$
1	Curb	Cock Valve T.S. & V.	3/4" in.	\$
1	Service box	Short 3 1/2 x 4 1/2		
	Old returned	Long 4 1/2 x 5 1/2		
		Buff or Rdway		\$
15	Ft.	3/4" in. Copper G.I. G.I.	Pipe at	\$
	Nipples	in. at		\$
	Bushings	to in. at		\$
	Red'g Inc'g	Coupl'gs to in. at		\$
	Union	in. at		\$
	Meter	in. at		\$
	Lead Joints	at		\$
	Compound Joints	at		\$
	Maintenance Foreman			\$
	Hrs. Water Maint. Man-1	at		\$
	Hrs. Water Maint. Man-2	at		\$
	Hrs. Garage Foreman	at		\$
	Hrs. Labor	at		\$
	Hrs. Compressor	at		\$
	Compensation Ins.	at \$ per C		\$
	Trucking			\$
	Pav't Patch			\$
	Tap by Gifford			\$
	Tap Co.			\$
		8-8-63		\$
	O'head			\$


Lot # 5

Rd
St
Pl

Windy Hill Ave. No. 6

Name of Owner
~~J. Wheeler~~

Labor and Mat'l. Report Aug. 8 1963

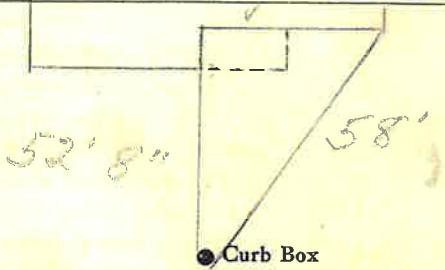

6" Main Elev. of Main at tap 5'

Gate at • Gate at

15' to main

Wayne Ash,
TAX ID # 303.9-7-2