


LABOR AND MATERIALS

1	Copper Lead	Connection	$\frac{3}{4}$ "	\$	_____
1	Curb	Cook Valve T.S. & V.	criseal.	\$	_____
1	Service box	Short $3\frac{1}{2}$ x $4\frac{1}{2}$		\$	_____
	Old returned	Long $4\frac{1}{2}$ x $5\frac{1}{2}$		\$	_____
		Buff or Rdway		\$	_____
34	Ft. $\frac{3}{4}$ in.	Copper G.I. C.I.	Pipe at	\$	_____
	Nipples	in. at		\$	_____
	Bushings	to in. at		\$	_____
	Red'g Inc'g	Coupl'gs to in. at		\$	_____
	Union	in. at		\$	_____
	Meter	in. at		\$	_____
	Lead Joints	at		\$	_____
	Compound Joints	at		\$	_____
	Maintenance Foreman			\$	_____
	Hrs. Water Maint. Man-1	at		\$	_____
	Hrs. Water Maint. Man-2	at		\$	_____
	Hrs. Garage Foreman	at		\$	_____
	Hrs. Labor	at		\$	_____
	Hrs. Compressor	at		\$	_____
	Compensation Ins.	at \$ per C		\$	_____
	Trucking			\$	_____
	Pav't Patch			\$	_____
	Tap by Gifford + Co.			\$	_____
	4-27-64.			\$	_____
	O'head			\$	_____
				\$	_____

Rd. Windy Hill
 St. 5
 Pl. Pl.
 Ave. No. 7
 Name of Owner John Wheeler
 TAX ID # 303.9-8-33

Labor and Mat'l. Report Apr. 27 - 1964.

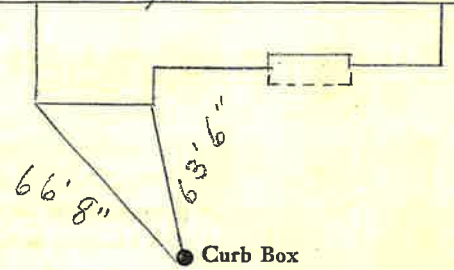

6" C.I. Main Elev. of Main at tap 5'

Gate at • Gate at •

34' to main

• Curb Box