

LABOR AND MATERIALS


1 Copper Lead } Connection $\frac{3}{4}$ " \$
 1 Curb } Cock Valve } $\frac{3}{4}$ in. or 1 seat \$
 } T.S. & V. }
 1 Service box } Short $3\frac{1}{2} \times 4\frac{1}{2}$ }
 Old returned } Long $4\frac{1}{2} \times 5\frac{1}{2}$ } \$
 } Buff or Rdway }
 12 Ft. $\frac{3}{4}$ in. } Copper } Pipe at \$
 } G.I. }
 } G.I. }
 Nipples in. at \$
 Bushings to in. at \$
 Red'g }
 Inc'g } Coupl'gs to in. at \$
 Union in. at \$
 Meter in. at \$
 Lead Joints at \$
 Compound Joints at \$
 Maintenance Foreman \$
 Hrs. Water Maint. Man-1 at \$
 Hrs. Water Maint. Man-2 at \$
 Hrs. Garage Foreman at \$
 Hrs. Labor at \$
 Hrs. Compressor at \$
 Compensation Ins. at \$ per C \$
 Trucking \$
 Pav't Patch \$
 Tap by Gifford & Co. \$
 11-9-65 \$
 O'head \$
 \$

Windy Hill Rd.
 St. Ave. No. 8
 Pl.

Name of Owner John Wheeler

TAX ID # 303.9-7-3

Labor and Mat'l. Report Nov. 9 19 65

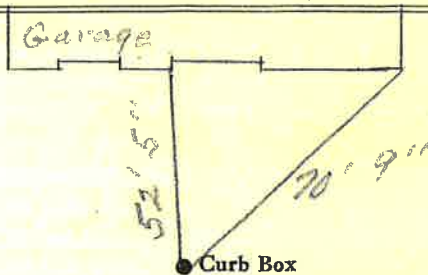

6" Main

Elev. of Main at tap $5\frac{1}{2}$

Gate at ●

● Gate at

12' to main

● Curb Box