


LABOR AND MATERIALS

1	Copper Lead	Connection	3/4"	\$
1	Curb	Cock Valve T.S. & V.	3/4" or seal.	\$
1	Service box - Old returned	Short 3 1/2 x 4 1/2 Long 4 1/2 x 5 1/2 Buff or Rdway		\$
36	Ft.	3/4 in. { Copper G.I. C.I. } Pipe at		\$
	Nipples	in. at		\$
	Bushings	to in. at		\$
	Red'g } Inc'g }	Coupl'gs to in. at		\$
	Union	in. at		\$
	Meter	in. at		\$
	Lead Joints	at		\$
	Compound Joints	at		\$
	Maintenance Foreman			\$
	Hrs. Water Maint. Man-1	at		\$
	Hrs. Water Maint. Man-2	at		\$
	Hrs. Garage Foreman	at		\$
	Hrs. Labor	at		\$
	Hrs. Compressor	at		\$
	Compensation Ins. at \$	per C		\$
	Trucking			\$
	Pay't Patch			\$
	Tap by Gifford & Co.			\$
	6-24-63.			\$
	O'head			\$

Rd. Lot-12
St.
Pl.
Ave. No. 9

Windy Hill
Name of Owner J. Wheeler.
TAX ID # 303.9-8-31

Labor and Mat'l. Report June 24 1963

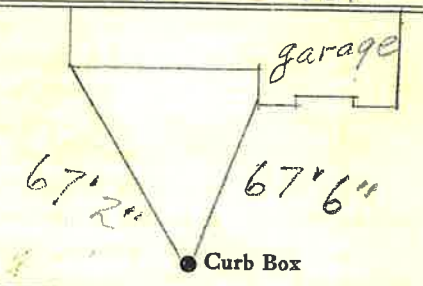

6" C.I. Main Elev. of Main at tap 5'

Gate at • Gate at •

36' to main

• Curb Box