

LABOR AND MATERIALS


Copper	} Connection	_____	\$	_____	
Lead					
Curb	} Cock } Valve } T. S. & V.	_____ in.	\$	_____	
Service box		} Short 3½ x 4½ } Long 4½ x 5½			
Old returned				\$	_____
Ft. _____ in.	} Copper } G. I. } C. I.	Pipe at _____	\$	_____	
Nipples _____ in.		at _____	\$	_____	
Bushings _____ to _____ in.		at _____	\$	_____	
Red'g } In'g }	} Coupl'gs	_____ to _____ in.	at _____	\$	
Union _____ in.		at _____	\$	_____	
Meter _____ in.	at _____	\$	_____		
_____			\$	_____	
Compound Joints	at _____	\$	_____		
Maintenance Foreman	_____	\$	_____		
Hrs. Water Maint. Man—1	at _____	\$	_____		
Hrs. Water Maint. Man—2	at _____	\$	_____		
Hrs. Garage Foreman	at _____	\$	_____		
Hrs. Labor—	at _____	\$	_____		
Hrs. Compressor	at _____	\$	_____		
_____			\$	_____	
Trucking	_____	\$	_____		
Pav't Patch	_____	\$	_____		
_____			\$	_____	
_____			\$	_____	
DR.
ST.
PL.
Ave. No. 17
WINDY RIDGE

Name of Owner _____

Labor and Mat'l. Report

1995

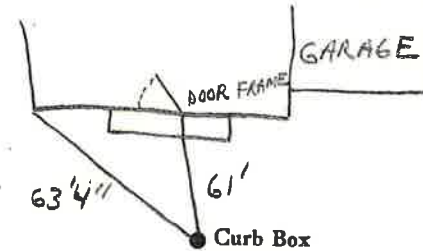

_____ Main	Elev. of Main at tap _____
Gate at ●	● Gate at

● Curb Box