

LABOR AND MATERIALS

Copper	} Connection	_____	\$ _____			
Lead						
Curb	} Cock Valve T. S. & V.	} _____ in.	\$ _____			
				Service box	} Short 3½ x 4½	\$ _____
Ft. _____ in.	} Copper <del>C.I.</del> <del>C.I.</del>	} Pipe at _____	\$ _____			
Nipples _____ in.				at _____	\$ _____	
Bushings _____ to _____ in.				at _____	\$ _____	
Red'g Inc'g	} Coupl'gs	} to _____ in.	at _____ \$ _____			
Union _____ in.				at _____ \$ _____		
Meter _____ in.	at _____	\$ _____				
_____			\$ _____			
Compound Joints	at _____	\$ _____				
Maintenance Foreman	_____	\$ _____				
Hrs. Water Maint. Man—1	at _____	\$ _____				
Hrs. Water Maint. Man—2	at _____	\$ _____				
Hrs. Garage Foreman	at _____	\$ _____				
Hrs. Labor—	at _____	\$ _____				
Hrs. Compressor	at _____	\$ _____				
_____			\$ _____			
Trucking	_____	\$ _____				
Pav't Patch	_____	\$ _____				
_____			\$ _____			
_____			\$ _____			
_____			\$ _____			
_____			\$ _____			


DR.  
~~St.~~  
~~St.~~  
Ave. No. 6

WINDY RIDGE

Name of Owner \_\_\_\_\_

TAX ID # 303.9-8-3

Labor and Mat'l. Report 1992

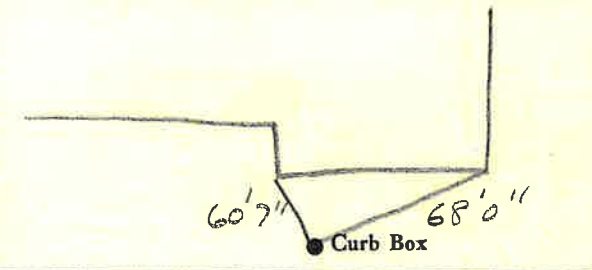

\_\_\_\_\_ Main Elev. of Main at tap \_\_\_\_\_

Gate at • • Gate at

\_\_\_\_\_

• Curb Box