


### LABOR AND MATERIALS

- \_\_\_\_\_ Copper } Connection \_\_\_\_\_ \$ \_\_\_\_\_
- \_\_\_\_\_ Lead } \_\_\_\_\_ \$ \_\_\_\_\_
- \_\_\_\_\_ Curb } Cock \_\_\_\_\_ in. \_\_\_\_\_ \$ \_\_\_\_\_
- \_\_\_\_\_ Valve } T.S. & V. } \_\_\_\_\_ \$ \_\_\_\_\_
- \_\_\_\_\_ Service box { Short 3-1/2 x 4-1/2 } \_\_\_\_\_ \$ \_\_\_\_\_
- \_\_\_\_\_ Old returned { Long 4-1/2 x 5-1/2 } \_\_\_\_\_ \$ \_\_\_\_\_
- \_\_\_\_\_ Ft. 3/4 in. { Copper } Pipe at \_\_\_\_\_ \$ \_\_\_\_\_
- \_\_\_\_\_ G.I. } \_\_\_\_\_
- \_\_\_\_\_ C.I. } \_\_\_\_\_
- \_\_\_\_\_ Nipples \_\_\_\_\_ in. at \_\_\_\_\_ \$ \_\_\_\_\_
- \_\_\_\_\_ Bushings \_\_\_\_\_ to \_\_\_\_\_ in. at \_\_\_\_\_ \$ \_\_\_\_\_
- \_\_\_\_\_ Red'g \_\_\_\_\_
- \_\_\_\_\_ Inc'g \_\_\_\_\_
- \_\_\_\_\_ Union \_\_\_\_\_ in. at \_\_\_\_\_ \$ \_\_\_\_\_
- \_\_\_\_\_ Meter \_\_\_\_\_ in. at \_\_\_\_\_ \$ \_\_\_\_\_
- \_\_\_\_\_ \$ \_\_\_\_\_
- \_\_\_\_\_ Compound Joints at \_\_\_\_\_ \$ \_\_\_\_\_
- \_\_\_\_\_ Maintenance Foreman \_\_\_\_\_ \$ \_\_\_\_\_
- \_\_\_\_\_ Hrs. Water Maint. Man - 1 at \_\_\_\_\_ \$ \_\_\_\_\_
- \_\_\_\_\_ Hrs. Water Maint. Man - 2 at \_\_\_\_\_ \$ \_\_\_\_\_
- \_\_\_\_\_ Hrs. Garage Foreman \_\_\_\_\_ at \_\_\_\_\_ \$ \_\_\_\_\_
- \_\_\_\_\_ Hrs. Labor \_\_\_\_\_ at \_\_\_\_\_ \$ \_\_\_\_\_
- \_\_\_\_\_ Hrs. Compressor at \_\_\_\_\_ \$ \_\_\_\_\_
- \_\_\_\_\_ \$ \_\_\_\_\_
- \_\_\_\_\_ Trucking \_\_\_\_\_ \$ \_\_\_\_\_
- \_\_\_\_\_ Pav't Patch \_\_\_\_\_ \$ \_\_\_\_\_
- \_\_\_\_\_ \$ \_\_\_\_\_
- \_\_\_\_\_ \$ \_\_\_\_\_
St. Windy Ridge  
 Pl. 7  
 Ave. No. 7

Name of Owner \_\_\_\_\_  
Gary Mikutel  
 TAX ID # 303.9-8-17

Labor and Mat'l. Report to 2003

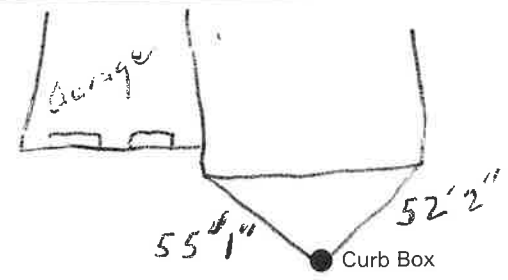

6" Main Elev. of Main at tap \_\_\_\_\_

Gate at ● Gate at ●

● Curb Box