

LABOR AND MATERIALS

Copper	} Connection		\$	
Lead				
Curb	} Cock Valve T. S. & V. }	in.	\$	
Service box		} Short 3½ x 4½ Long 4½ x 5½ }		
Old returned				\$
Ft.	} Copper G. I. C. I. }	in.	Pipe at \$	
Nipples		in. at	\$	
Bushings		to in. at	\$	
Red'g Inc'g	} Coupl'gs	to in. at	\$	
Union		in. at	\$	
Meter	in. at	\$		
Compound Joints	at	\$		
Maintenance Foreman		\$		
Hrs. Water Maint. Man-1	at	\$		
Hrs. Water Maint. Man-2	at	\$		
Hrs. Garage Foreman	at	\$		
Hrs. Labor	at	\$		
Hrs. Compressor	at	\$		
Trucking		\$		
Pav't Patch		\$		
		\$		
		\$		
DR
~~St.~~
~~Pl.~~
 Ave. No. 10


WINDY RIDGE

Name of Owner

MELROSE

Labor and Mat'l. Report

19 95

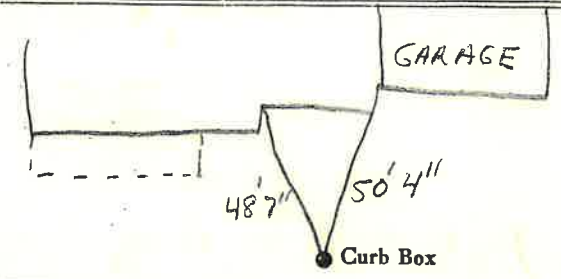

Main Elev. of Main at tap

Gate at • Gate at

TAX ID# 303.9-8-5

• Curb Box