

LABOR AND MATERIALS

Copper	} Connection	_____	\$ _____	
Lead				
Curb	} Cock Valve T. S. & V. }	_____ in.	\$ _____	
Service box		} Short 3½ x 4½ Long 4½ x 5½ }		
Old returned				\$ _____
Ft. _____ in.	} Copper G. I. C. I. }	Pipe at _____	\$ _____	
Nipples _____ in.		at _____	\$ _____	
Bushings _____ to _____ in.		at _____	\$ _____	
Red'g } Inc'g }	} Coupl'gs	_____ to _____ in.	at _____ \$ _____	
Union _____ in.		at _____	\$ _____	
Meter _____ in.	at _____	\$ _____		
_____			\$ _____	
Compound Joints	at _____	\$ _____		
Maintenance Foreman		\$ _____		
Hrs. Water Maint. Man—1	at _____	\$ _____		
Hrs. Water Maint. Man—2	at _____	\$ _____		
Hrs. Garage Foreman	at _____	\$ _____		
Hrs. Labor—	at _____	\$ _____		
Hrs. Compressor	at _____	\$ _____		
_____		\$ _____		
Trucking		\$ _____		
Pav't Patch		\$ _____		
_____		\$ _____		
_____		\$ _____		
_____		\$ _____		
_____		\$ _____		

WINDY RIDGE


Think  
DR 15  
St.  
Pt.  
Ave. No. 13

Name of Owner

TAX ID # 303.9-8-13

Labor and Mat'l. Report

1995

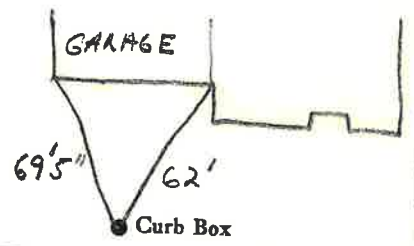

_____ Main	Elev. of Main at tap _____
Gate at ●	● Gate at
_____	
_____	
	● Curb Box