

LABOR AND MATERIALS


Copper	} Connection	_____	\$ _____
Lead			
Curb	} Cock Valve T.S. & V. }	_____ in.	\$ _____
Service box	} Short 3 1/2 x 4 1/2 } Long 4 1/2 x 5 1/2 }	_____	\$ _____
Old returned			
Ft. 3/4 in.	} Copper C.I. C.I. }	Pipe at _____	\$ _____
Nipples	in. at _____		\$ _____
Bushings	to _____ in. at _____		\$ _____
Red'g } Inc'g }	} Coupl'gs	to _____ in. at _____	\$ _____
Union		in. at _____	\$ _____
Meter	in. at _____		\$ _____
			\$ _____
			\$ _____
Compound Joints	at _____		\$ _____
Maintenance Foreman			\$ _____
Hrs. Water Maint. Man-1	at _____		\$ _____
Hrs. Water Maint. Man-2	at _____		\$ _____
Hrs. Garage Foreman	at _____		\$ _____
Hrs. Labor	at _____		\$ _____
Hrs. Compressor	at _____		\$ _____
			\$ _____
Trucking			\$ _____
Pav't Patch			\$ _____
			\$ _____
			\$ _____
			\$ _____

DR.
~~St.~~
~~Pt.~~
Ave. No. 16

WINDY RIDGE

Name of Owner
Poulos

Labor and Mat'l. Report 1993

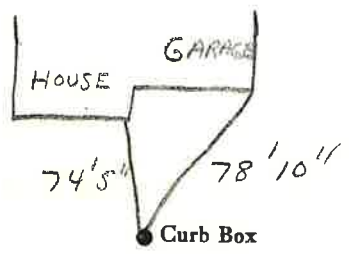

Main Elev. of
Main at tap

Gate at ● ● Gate at

TAX ID# 303.9-8-8

● Curb Box