

Labor and Materials

Copper	} Connection.....	3 x	\$ 1.50	
Lead					
Curb	} Valve T.S.&V.	} in	3	\$ 1.70	
Cock					
Service Box	} Short 3 1/2 x 4 1/2 Long 4 1/2 x 5 1/2 Buff. or Rdwa.	}	\$ 1.44	
Old returned					
30 Ft.	} Copper Galv. Iron Cast Iron	} in	\$ 5.70	
Nipples	in. at	\$	
Bushings	to	in. at	\$
Red'g Inc'g	} Couplings.....	} to	in. at	\$
Union	in. at	\$	
Meter	in. at	\$	
Lbs. Br. Stone	at	\$	
Lbs. Sand	at	\$	
Bags Cement	at	\$	
Paving Brick	} Mack Red Asphalt	} at	\$	
Lead Joints					
Leadite Joints	at	\$	
9 Hrs. Foreman	at	6 1/2	\$ 5.63	
7 Hrs. Common Labor	at	50	\$ 3.50	
12 Hrs. Common Labor	at	45	\$ 5.40	
Hrs. Mason	at	\$	
Hrs. Masons Helper	at	\$	
Hrs. Compressor	at	\$	
Compensation Ins	\$ 0.50	
Trucking	\$ 2-	
Builders Use of Water	Pave Patch	\$ 5-	


Total \$ 32.39

3 34

Labor and Material Report

March 7 1931

10 *WINDY ST*

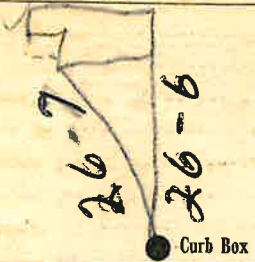

4 Main Elev. of Main at tap

Gate at ● ● Gate at
30' to main

● Curb Box

*old top shut off at
main*

MS

TAX ID # 303.13-1-5

MS