

### LABOR AND MATERIALS

1. Copper Connection $\frac{3}{4}$ .....	\$ 2.94
1. Lead { Cock	} $\frac{3}{4}$ in. \$ 3.71
1. Curb { Valve	
T. S. & V.	
Service box { Short $3\frac{1}{2}$ X $4\frac{1}{2}$	} Same \$ —
Old returned { Long $4\frac{1}{2}$ X $5\frac{1}{2}$	
Buff or Rdway	
28. Ft. $\frac{3}{4}$ in. { Copper	} Pipe at 30 \$ 8.40
{ G. I.	
{ C. I.	
1. Nipples $\frac{3}{4}$ in. at 2" long brass	\$ .18
Bushings 4 to in. at	\$
Red'g	
Inc'g { Coupl'gs $\frac{3}{4}$ to 1 in. at	\$ .17
Union in. at	\$
Meter in. at	\$
Lead Joints at	\$
Compound Joints at	\$
2. Hrs. Water Maint. Man-1 at 1.12	\$ 2.24
8. Hrs. Water Maint. Man-2 at 1.02	\$ 8.16
13. Hrs. Labor at 91	\$ 11.93
Hrs. Labor at	\$
2. Hrs. Compressor at 1.20	\$ 2.40
Compensation Ins. at \$ per C	\$ 49
Trucking	\$ 1.00
Pav't Patch	\$ 16.00
<i>Tap by M. J. ...</i>	
O'head	\$
	\$ 57.52

122

St.

Pl.


Ave. No. 16

Name of Owner

Jenkins

Labor and Mat'l. Report

Sept 16 1948

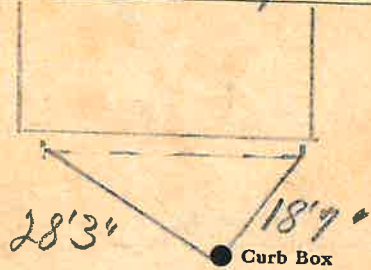

4 Main

Elev. of

Main at tap 6

Gate at ●

● Gate at

28' to MAIN

● Curb Box

TAX ID# 303.13-1-9