


**Labor and Materials**

1	Copper } Connection $\frac{3}{4}$ "	\$ 3 20
	Lead	
1	Curb } Cock Valve T.S. & V. } $\frac{3}{4}$ " in.	\$ 1 00
1	Service Box } Short $3\frac{1}{2}$ x $4\frac{1}{2}$ } Old returned } Long $4\frac{1}{2}$ x $5\frac{1}{2}$ } } Buil. or Rdway }	\$ 13 0
9	Ft. $\frac{3}{4}$ " in. } Copper Galv. Iron } Pipe at	\$ 198
	Nipples..... in. at.....	\$
	Bushings..... to..... in. at.....	\$
	Red'g } Couplings..... to..... in. at..... Inc'g }	\$
	Union..... in. at.....	\$
	Meter..... in. at.....	\$
	Lbs. Br. Stone at.....	\$
	Lbs. Sand at.....	\$
	Bags Cement at.....	\$
	Paving Brick } Mack Red Asphalt } at.....	\$
	Lead Joints at.....	\$
	Leadite Joints at.....	\$
1	Hrs. Foreman at.....	\$ 63
4	Hrs. Common Labor at.....	\$ 200
7	Hrs. Common Labor at..... $\frac{40}{100}$	\$ 284
	Hrs. Mason at.....	\$
	Hrs. Mason's Helper at.....	\$
	Hrs. Compressor at.....	\$
	Compensation Ins.....	\$ 14
	Trucking.....	\$ 120
	Builders' Use of Water.....	\$
Total \$		14.09

28-25

Labor and Material Report Apr 20 1929

$\frac{3}{4}$ " tap at 17 Wing st

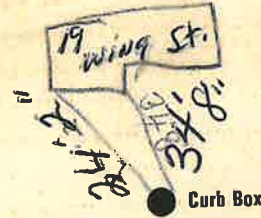

4" Main Elev. of Main at tap 7  
 Gate at ● 9' to main Gate at ●

● Curb Box  
 Old curb ~~to be dug up~~  
 Dug up + shut off  
 Apr 21-28  
 By Jack Kim +  
 Person

TAX ID # 303.13-2-12