

LABOR AND MATERIALS


1	Copper	Connection	3/4"	\$
1	Curb	Cock Wave F.C. & W.	3/4 in. DRISDAI	\$
1	Service box Old returned	Short 3 1/2 x 4 1/2 Long 4 1/2 x 5 1/2 Buff or Rdway		\$
14	Ft. 3/4 in.	Copper Pipe at		\$
	Nipples	in. at		\$
	Bushings	to in. at		\$
	Red'g Inc'g	Coupl'gs to in. at		\$
	Union	in. at		\$
	Meter	in. at		\$
	Lead Joints	at		\$
	Compound Joints	at		\$
	Maintenance Foreman			\$
	Hrs. Water Maint. Man-1	at		\$
	Hrs. Water Maint. Man-2	at		\$
	Hrs. Garage Foreman	at		\$
	Hrs. Labor-	at		\$
	Hrs. Compressor	at		\$
	Compensation Ins. at \$	per C		\$
	Trucking			\$
	Pav't Patch			\$
	O'head			\$

TAP MADE BY ST. JOHN & CO
DEC-15-1975

St. Pt. Ave. No. 19
WING ST

Name of Owner
ALAN COMBS

Labor and Mat'l. Report DEC. 15 1975

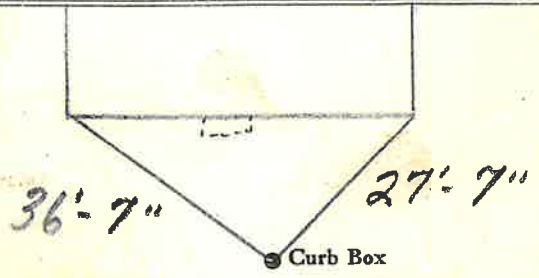

4" Main Elev. of Main at tap 6'-7"

Gate at • Gate at

14' TO MAIN

• Curb Box

TAX ID # 303.13-2-11