

LABOR AND MATERIALS


1	Copper Lead	Connection	3/4	\$ 1.79
1	Curb	Clock Valve T. S. & V.	3/4 in.	\$ 2.61
1	Service box Old returned	Short 3 1/2 X 4 1/2 Long 4 1/2 X 5 1/2 Buff or Rdway		\$ 1.82
23	Ft.	Copper Galv. Iron Cast Iron	Pipe at	\$ 7.13
	Nipples	in. at		\$
	Bushings	to in. at		\$
	Red'g Inc'g	Couplings	to in. at	\$
	Union	in. at		\$
	Meter	in. at		\$
	Lead Joints	at		\$
	Compound Joints	at		\$
1	Hrs. Foreman at	WWM 9 2 1/2		\$ 93
11	Hrs. Chauffeur at	8 2 1/2		\$ 907
	Hrs. Tapper at			\$
11	Hrs. Labor at	7 1 1/2		\$ 787
	Hrs. Labor at			\$
2	Hrs. Compressor at	8 7 1/2		\$ 175
	Compensation Ins.			\$ 49
	Trucking			\$ 1.00
	Builders Use of Water			\$ 5.00
	<i>Topsy Walszinski</i>			\$
				\$
				\$
				\$
				\$
				\$ 39.46

77-46

St. Wing St  
Pl. Ave. No. 20

Name of Owner  
Nolan

Labor and Mat'l. Report Aug 22 19-16

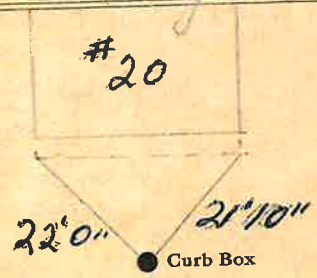

4 Main Elev. of Main at tap 7

Gate at ● Gate at ●

31' to main

● Curb Box

TAX ID # 303.13-1-11