


Labor and Materials

1	Lead Connection ^{1/2"}	\$
1	Curb Cock ^{3/4"}	\$
1	Service Box { Short 3 1/2 x 4 1/2 Old returned { Long 4 1/2 x 5 1/2 Buffalo	\$
6	Ft. 3/4 in. G. I. Pipe at	\$
	Nipples in. at	\$
	Bushings in. at	\$
	Red'g Coup to in. at	\$
	Inc'g Coup to in. at	\$
	Union in. at	\$
	Meter in. at	\$
	Cu. Yds. Br. Stone at	\$
	Cu. Yds. Sand at	\$
	Bags Cement at	\$
	Pav. Brick { Mack Red Asphalt } at	\$
2	Hrs. Foreman at	\$
2	Hrs. Com. Labor at	\$
	Hrs. Mason at	\$
	Hrs. at	\$
	Hrs. at	\$
	Builders' Use of Water at	\$
	TRUCK 1.00 at	\$
	at	\$
	at	\$
	at	\$
	Total \$	7.54

Labor and Material Report June 26 1923

1/2" tap 21 wing at

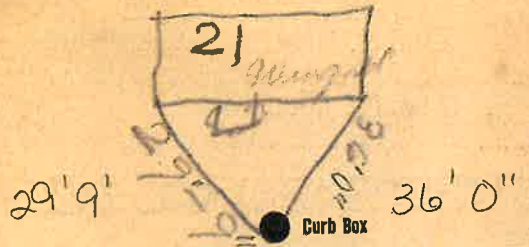

4" Main Elev. of Main at tap 4 1/2

Gate at 3/4" GI 6' to main Gate at

Curb Box

TAX ID # 303.13-2-10