


LABOR AND MATERIALS

1	Copper	Connection	3/4	\$	1.79
1	Curb	Clock Valve T.S. & V.	3/4 in.	\$	2.61
	Service box	Short 3 1/2 X 4 1/2	} Same \$ -		
	Old returned	Long 4 1/2 X 5 1/2			
		Buff or Rdway	Box		
30	Ft.	3/4 in.	Copper Galv. Iron Cast Iron	Pipe at 23	\$ 6.90
	Nipples	in. at		\$	
	Bushings	to in. at		\$	
	Red'g Inc'g	Couplings	to in. at	\$	
	Union	in. at		\$	
	Meter	in. at		\$	
	Lead Joints	at		\$	
	Compound Joints	at		\$	
	Hrs. Foreman	at		\$	
1.0	Hrs. Chauffeur	at	8 1/2	\$	8.25
	Hrs. Tapper	at		\$	
2.4	Hrs. Labor	at	7 1/2	\$	17.16
	Hrs. Labor	at		\$	
	Hrs. Compressor	at		\$	
	Compensation Ins.			\$	70
	Trucking			\$	1.00
	Builders Use of Water			\$	5.00
	Taps by Waismske				
				\$	
				\$	
				\$	43.41

44 46
 St. Wing
 Pl. Ave. No. 22

Name of Owner
 Marson

Labor and Mat'l. Report Aug 15 1946

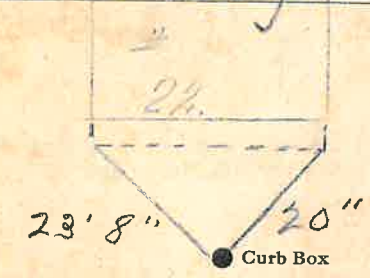

4 Main Elev. of Main at tap 6
 Gate at ● Gate at ●

30' to main

● Curb Box

TAX ID# 303.13-1-12