

LABOR AND MATERIALS

1	Copper Lead	{ Connection	$\frac{3}{4}$		\$ 1.23
1	Curb	{ Cock Valve T. S. & V.	$\frac{3}{4}$	in.	\$ 1.68
1	Service Box Old returned	{ Short $3\frac{1}{2} \times 4\frac{1}{2}$ Long $4\frac{1}{2} \times 5\frac{1}{2}$ Buff. or Rdway			\$ 1.54
8	Ft. $\frac{3}{4}$ in.	{ Copper Galv Iron Cast Iron		Pipe at 17	\$ 1.36
	Nipples	in. at			\$
	Bushings	to in. at			\$
	Red'g' Inc'g	{ Couplings	to in. at		\$
	Union	in. at			\$
	Meter	in. at			\$
	Lead Joints	at			\$
	Leadite Joints	at			\$
	Hrs. Foreman	at			\$
4	Hrs. Chauffeur	at	62	$\frac{1}{2}$	\$ 2.50
7	Hrs. Tapper	at			\$ 4.38
7	Hrs. Labor	at	45		\$ 3.15
	Hrs. Labor	at			\$
	Hrs. Compressor	at			\$
	Compensation Ins.				\$.31
	Trucking				\$ 1.00
	Builders Use of Water	Patch			\$ 5.00
					\$
					\$
					\$ 22.15

87 - - 1939

St.

Wing

Ph


Ave. No. 23

Name of Owner

Flagg

Labor and Mat'l. Report

Sept 18 1939

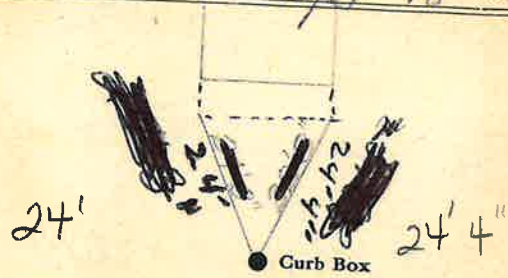

Main

Elev. of Main at tap 6

Gate at

Gate at

8' to main

Curb Box

TAX ID # 303.13-2-9

SW

old shut off