


Labor and Materials

Copper } Connection.....	$\frac{3}{4}$	\$ 96
Lead }		
Curb { Cock }	$\frac{3}{4}$	\$ 1.35
{ Valve }		
{ 4" C. & V. }		
Service Box { Short 2 1/2 x 4 1/2 }		\$ 1.35
Old returned { Long 4 1/2 x 6 1/2 }		
{ Both on Edger }		
2.9 Ft. ^{3/4"} in. { Copper } Pipe at 15		\$ 4.35
{ Galv. Iron }		
{ Cast Iron }		
Nipples	in. at	\$
Bushings	to	in. at
Red'g } Couplings.....	to	in. at
Inc'g }		
Union.....	in. at	\$
Meter.....	in. at	\$
Lbs. Br. Stone at		\$
Lbs. Sand at		\$
Bags Cement at		\$
Paving Brick { Mack } at		\$
{ Red }		
{ Asphalt }		
Lead Joints at		\$
Leadite Joints at		\$
Hrs. Foreman at		\$
Hrs. Common Labor at		\$
Hrs. Common Labor at		\$
Hrs. Mason at		\$
Hrs. Masons Helper at		\$
Hrs. Compressor at		\$
Compensation Ins		\$
Trucking		\$
Builders Use of Water	Patch	\$
Total \$.....		

36-36 24 APR 9 1936
 Labor and Material Report

24-26 Wing St

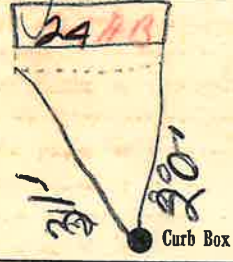

4 Main Elev. of Main at tap 6

Gate at • 29' 40 MAIN Gate at

● Curb Box

old shut off at main

TAX ID# 303.13-1-13