


Labor and Materials

1	Copper Lead	Connection	\$ 2.70	
1	Curb	Cock Valve T.S. & V. in.	\$ 2.34	
1	Service Box	Short 3 1/2 x 4 1/2	} Old returned Buff. or Rdway	\$ 1.45	
		Long 4 1/2 x 5 1/2			
26	Ft.	Copper Galv. Iron Cast Iron	Pipe at	\$ 7.02	
	Nipples in.	at	\$	
	Bushings to in. at	\$	
	Red'g Inc'g	Couplings to in. at	\$
	Union in.	at	\$	
	Meter in.	at	\$	
	Lbs. Br. Stone	at		\$	
	Lbs. Sand	at		\$	
	Bags Cement	at		\$	
	Paving Brick	Mack Red Asphalt	at	\$	
	Lead Joints	at		\$	
	Leadite Joints	at		\$	
7	Hrs. Foreman	at		\$ 1.25	
3	Hrs. Common Labor	at	Tag # 1050	\$ 1.50	
12	Hrs. Common Labor	at		\$ 5.40	
	Hrs. Mason	at		\$	
	Hrs. Mason's Helper	at		\$	
	Hrs. Compressor	at		\$	
	Compensation Ins.			\$.25	
	Trucking			\$ 1.00	
	Builders' Use of Water	Rate		\$ 5.00	

measured in
3-4-64
by Donovan & Lareau,
Total \$ 27.96

26
Labor and Material Report 11-15-1921

28 Wing St.

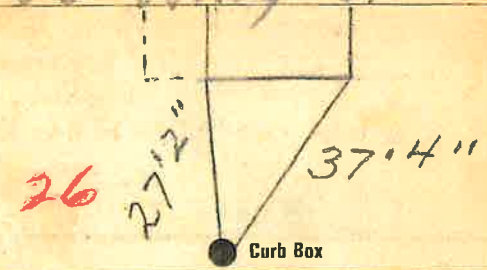

6" Main Elev of Main at tap 374

Gate at ● 26' to MAIN Gate at ●

● Curb Box

TAX ID # 303.9-12-1