


Labor and Materials

1	Copper	} Connection. ^{3/4"}	\$ 96
1	Lead			
1	Curb	} Cock Valve T.S.&V. } ^{3/4"} in	\$ 1.33
1	Service Box Old returned			
		} Short 3 1/2 x 4 1/2 } } Long 4 1/2 x 5 1/2 } } Buff. or Raw. }	\$ 1.35
9	Ft. ^{3/4"} in.			
		} Copper Galv. Iron Cast Iron }	Pipe at 15	\$ 1.35
	Nipples			
	Bushings to	in. at	\$
	Red'g Inc'g	} Couplings to	in. at
	Union			
	Meter in. at	\$	
	Lbs. Br. Stone	at	\$	
	Lbs. Sand	at	\$	
	Bags Cement	at	\$	
	Paving Brick	} Mack Red Asphalt }	at	\$
	Lead Joints			
	Leadite Joints	at	\$	
	Hrs. Foreman	at	\$	
	Hrs. Common Labor	at	\$	
	Hrs. Mason	at	\$	
	Hrs. Masons Helper	at	\$	
	Hrs. Compressor	at	\$	
	Compensation Ins	\$	
	Trucking	\$	
	Builders Use of Water	^{Patch}	\$ 5.00	
Total \$				

*3 Winy St - 3/4" Tap
Fitzgerald*

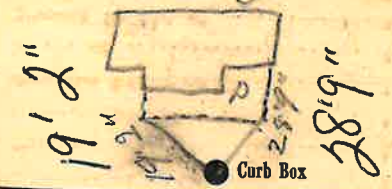

4 Main Elev. of Main at tap *4 1/2*

Gate at • *9' to main* • Gate at

● Curb Box

Old tap shut off

tlb

TAX ID # 303.13-2-18