

Labor and Materials


Copper	} Connection.....	\$ 1.75	
Lead			
Curb	{ Cock Valve T.S.&V. } .....	in .....	\$ 1.70
Service Box		{ Short 3 1/2 x 4 1/2 Long 4 1/2 x 5 1/2 } .....	
Old returned	{ Buff. or Rdway }		
Ft. 3/4 in.	{ Copper Galv. Iron Cast Iron } Pipe at	12 1/2	\$ 1.28
Nipples	in. at		\$
Bushings	to .....	in. at	\$
Red'g Inc'g	} Couplings.....to.....	in. at	\$
Union		in. at	\$
Meter	in. at	\$	
Lbs. Br. Stone	at	\$	
Lbs. Sand	at	\$	
Bags Cement	at	\$	
Paving Brick	{ Mack Red Asphalt } at		\$
Lead Joints		at	\$
Leadite Joints	at	\$	
4 Hrs. Foreman	at	62 1/2	\$ 2.50
5 Hrs. Common Labor	at	45	\$ 2.25
Hrs. Common Labor	at		\$
Hrs. Mason	at		\$
Hrs. Masons Helper	at		\$
Hrs. Compressor	at		\$
Compensation Ins			\$ .18
Trucking			\$ 1-
Builders Use of Water	Patch		\$ 5-
Total			\$ 16.33

1935-165

Labor and Material Report

19

Wing St

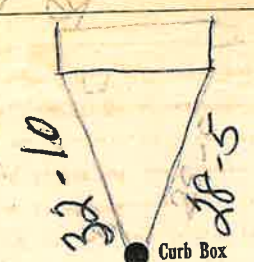

Main

Elev of Main at tap

Gate at

8' to main

Gate at

Curb Box

old shut off at main

TAX ID# 303.13-2-16

*[Handwritten signature]*