


LABOR AND MATERIALS

1	Copper	Connection	3/4"	\$
1	Lead	Cock		\$
1	Curb	Valve	3/4 in. Oriscat	\$
		F.S. & V.		
1	Service box	Short 3 1/2 x 4 1/2		\$
	Old returned	Long 4 1/2 x 5 1/2		\$
		Buff or Rdway		\$
29	Ft. in.	Copper	Pipe at	\$
				\$
	Nipples	in. at		\$
	Bushings	to in. at		\$
	Red'g			\$
	Inc'g	Coupl'gs. to in. at		\$
	Union	in. at		\$
	Meter	in. at		\$
	Lead Joints	at		\$
	Compound Joints	at		\$
	Maintenance Foreman			\$
	Hrs. Water Maint. Man-1	at		\$
	Hrs. Water Maint. Man-2	at		\$
	Hrs. Garage Foreman	at		\$
	Hrs. Labor	at		\$
	Hrs. Compressor	at		\$
	Compensation Ins.	at \$ per C		\$
	Trucking			\$
	Pav't Patch			\$
	Tap by Gifford & Co.			\$
	9-14-67.			\$
	O'head			\$

St. Wing
 Pl. 8
 Ave. No. 8

Name of Owner David Thomas.

Labor and Mat'l. Report Sept. 14 19 67.

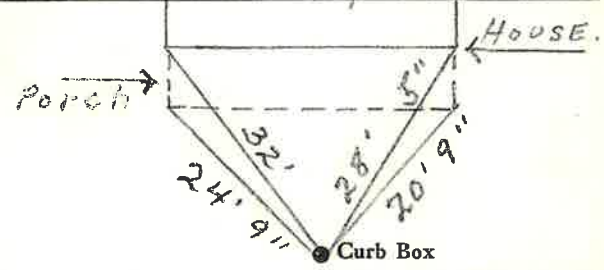

4" Main Elev. of Main at tap 5 1/2'

Gate at • Gate at •
29' to main

• Curb Box

TAX ID# 303.13-1-4