


LABOR AND MATERIALS

1	Copper	Connection	3/4"	\$	2.76
1	Lead	Cock Valve	3/4" in.	\$	3.49
1	Service box	Short 3 1/2 X 4 1/2		\$	4.74
	Old returned	Long 4 1/2 X 5 1/2		\$	
8	Ft.	Buffer Rdway	3/4 in.	\$	2.80
		Copper	Pipe at 35	\$	
		G. I.		\$	
		C. I.		\$	
	Nipples	in. at		\$	
	Bushings	to in. at		\$	
	Red'g			\$	
	Inc'g	Coupl'gs to in. at		\$	
	Union	in. at		\$	
	Meter	in. at		\$	
	Lead Joints	at		\$	
	Compound Joints	at		\$	
	Hrs. Water Maint. Man-1	at		\$	
4	Hrs. Water Maint. Man-2	at	1.24	\$	4.96
1.4	Hrs. Labor-	at	1.13	\$	15.82
	Hrs. Labor-	at		\$	
	Hrs. Compressor	at		\$	
	Compensation Ins.	at \$3.706 per C.		\$	7.7
	Trucking			\$	1.52
	Pav't Patch			\$	12.15
	Tap by Gifford	8-13-52		\$	
	O'head			\$	
				\$	48.49

St. Wing
 Pt. 9
 Ave. No. 9
 Name of Owner Combs

Labor and Mat'l. Report Aug 13 1952

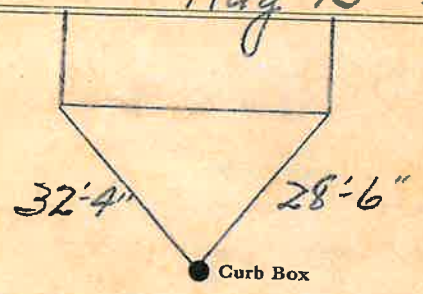

4" Main Elev. of Main at tap 5 1/2'
 Gate at ● Gate at ●

8' to main

● Curb Box

TAX ID# 303.13-2-15