


LABOR AND MATERIALS

1	Copper Lead	Connection	3/4"	\$	2.71
1	Curb	Cock Valve T.S. & V.	3/4 in.	\$	3.83
1	Service box Old returned	Short 3 1/2 x 4 1/2 Long 4 1/2 x 5 1/2 Buff or Rdway		\$	4.69
27	Ft.	Copper G.I. Pipe at	3/4 in. 45	\$	12.15
	Nipples	in. at		\$	
	Bushings	to in. at		\$	
	Red'g Inc'g	Coupl'gs to in. at		\$	
	Union	in. at		\$	
	Meter	in. at		\$	
	Lead Joints	at		\$	
	Compound Joints	at		\$	
	Maintenance Foreman			\$	
	Hrs. Water Maint. Man	1 at		\$	33.94
	Hrs. Water Maint. Man	2 at		\$	
	Hrs. Garage Foreman	at	1.59	\$	7.95
	Hrs. Labor	at	1.13	\$	25.99
	Hrs. Compressor	at		\$	
	Compensation Ins.	at \$ 4.29 per C.		\$	1.46
	Trucking			\$	1.50
	Pay't Patch			\$	15.68
	Tap by Larcav	7-20-55		\$	
	O'head			\$	
				\$	75.96

Woodard St. Pt. Ave. No. 21

Name of Owner Hovey

Labor and Mat'l. Report July 20 19 55

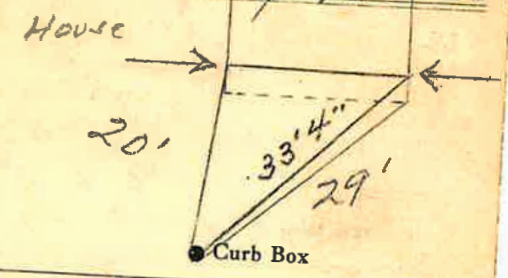

6" Main Elev. of Main at tap 4'

Gate at ● Gate at ● 27' to main

● Curb Box

TAX ID # 309.15-9-14