

WOODARD


St. Pl. Ave. No. 22

Name of Owner

TAX ID# - 309.15-10-3

Labor and Mat'l. Report

2018

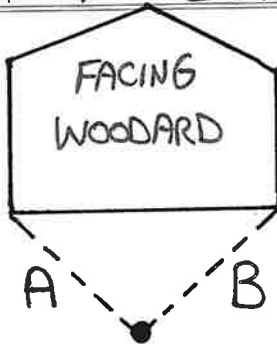

_____ Main

Elev. of Main at tap _____

Gate at ●

● Gate at

● Curb Box

TAP ON WOODARD

A - 28'8"

B - 36'0"