


LABOR AND MATERIALS

1 Copper } Connection $\frac{3}{4}$ " \$
~~Lead~~ }
 1 Curb } Cock } $\frac{3}{4}$ " in. \$
 } Valve }
 } F. S. & V. }
 1 Service box { Short $3\frac{1}{2}$ x $4\frac{1}{2}$ }
 Old returned { Long $4\frac{1}{2}$ x $5\frac{1}{2}$ }
 { Buff or Rdway } \$
 29 Ft. $\frac{3}{4}$ in. { Copper } Pipe at \$
 { G. I. }
 { C. I. }
 Nipples in. at \$
 Bushings to in. at \$
 1 Red'g }
 1 Inc'g } Coupl'gs $\frac{3}{4}$ to $\frac{3}{4}$ in. at \$
 Union in. at *cop. to cop.* \$
 Meter in. at \$
 Lead Joints at \$
 Compound Joints at \$
 Maintenance Foreman \$
 Hrs. Water Maint. Man-1 at \$
 Hrs. Water Maint. Man-2 at \$
 Hrs. Garage Foreman at \$
 Hrs. Labor at \$
 Hrs. Compressor at \$
 Compensation Ins. at \$ per C \$
 Trucking \$
 Pav't Patch \$
Tap by Miller Gifford
+ Co. 6-17-18-57 \$
 O'head \$

St. ✓
 Pl. Woodard
 Ave. No. 25

Name of Owner Hovey

Labor and Mat'l. Report June 18 1957

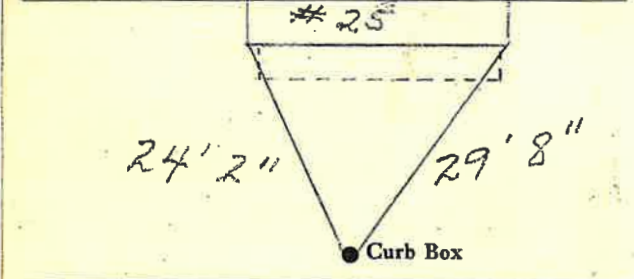

6 Main Elev. of Main at tap 4'

Gate at ● ● Gate at
29' to main

● Curb Box

TAX ID # 309.15-9-12