

# LABOR AND MATERIALS

\_\_\_\_\_ Copper } Connection \_\_\_\_\_ \$ \_\_\_\_\_  
 \_\_\_\_\_ Lead }  
 \_\_\_\_\_ Curb } Cock } \_\_\_\_\_ in. \$ \_\_\_\_\_  
 \_\_\_\_\_ Valve }  
 \_\_\_\_\_ T.S. & V. }  
 \_\_\_\_\_ Service box { Short 3-1/2 x 4-1/2 } \$ \_\_\_\_\_  
 \_\_\_\_\_ Old returned { Long 4-1/2 x 5-1/2 }  
 \_\_\_\_\_ Ft. \_\_\_\_\_ in. { Copper } Pipe at \_\_\_\_\_ \$ \_\_\_\_\_  
 \_\_\_\_\_ { G.I. }  
 \_\_\_\_\_ { C.I. }  
 \_\_\_\_\_ Nipples \_\_\_\_\_ in. at \_\_\_\_\_ \$ \_\_\_\_\_  
 \_\_\_\_\_ Bushings \_\_\_\_\_ to \_\_\_\_\_ in. at \_\_\_\_\_ \$ \_\_\_\_\_  
 \_\_\_\_\_ Red'g \_\_\_\_\_  
 \_\_\_\_\_ Inc'g \_\_\_\_\_  
 \_\_\_\_\_ Union \_\_\_\_\_ in. at \_\_\_\_\_ \$ \_\_\_\_\_  
 \_\_\_\_\_ Meter \_\_\_\_\_ in. at \_\_\_\_\_ \$ \_\_\_\_\_  
 \_\_\_\_\_ \$ \_\_\_\_\_  
 \_\_\_\_\_ Compound Joints at \_\_\_\_\_ \$ \_\_\_\_\_  
 \_\_\_\_\_ Maintenance Foreman \_\_\_\_\_ \$ \_\_\_\_\_  
 \_\_\_\_\_ Hrs. Water Maint. Man - 1 at \_\_\_\_\_ \$ \_\_\_\_\_  
 \_\_\_\_\_ Hrs. Water Maint. Man - 2 at \_\_\_\_\_ \$ \_\_\_\_\_  
 \_\_\_\_\_ Hrs. Garage Foreman \_\_\_\_\_ at \_\_\_\_\_ \$ \_\_\_\_\_  
 \_\_\_\_\_ Hrs. Labor \_\_\_\_\_ at \_\_\_\_\_ \$ \_\_\_\_\_  
 \_\_\_\_\_ Hrs. Compressor at \_\_\_\_\_ \$ \_\_\_\_\_  
 \_\_\_\_\_ \$ \_\_\_\_\_  
 \_\_\_\_\_ Trucking \_\_\_\_\_ \$ \_\_\_\_\_  
 \_\_\_\_\_ Pav't Patch \_\_\_\_\_ \$ \_\_\_\_\_  
 \_\_\_\_\_ \$ \_\_\_\_\_  
 \_\_\_\_\_ \$ \_\_\_\_\_  

WOODARD

St. Pl. Ave. No. 5

Name of Owner

TAX ID # 309.16-2-14

Labor and Mat'l. Report 19

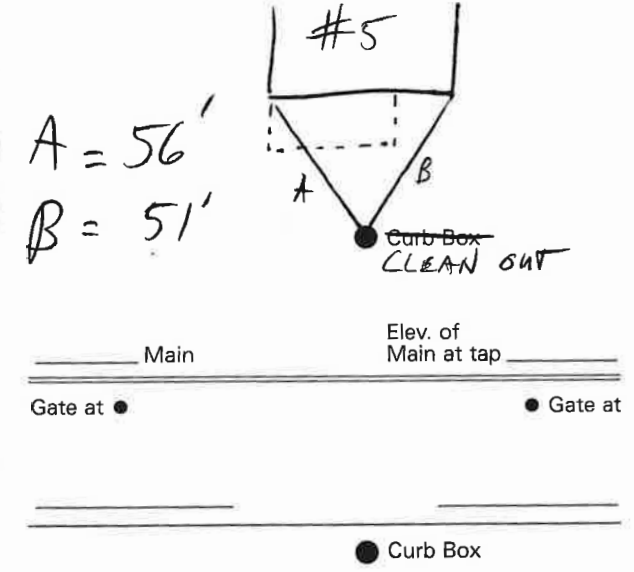

SEWER CLEAN OUT

LSM

#5

Porch

A

B

OUTSIDE Curb Box CLEAN OUT

A - 50' 7"

B - 45' 2"

---

Gate at ●

Gate at ●

Main at tap

Main

Elev. of Main at tap 4 1/2"

9"

---

Curb Box

94'-3"

96'-5"

---

Labor and Mat'l. Report Aug 6 1974

Name of Owner Joseph Gordon

Woodard

St. Pt. Ave. No. 5

St. Pt. Ave. No. 5

Woodard

Name of Owner Joseph Gordon

Labor and Mat'l. Report Aug 6 1974

Curb Box

94'-3"

96'-5"

Main

Elev. of Main at tap 4 1/2"

9"

Gate at ●

Gate at ●

26' to main

SEWER CLEAN OUT

LSM

#5

Porch

A

B

OUTSIDE Curb Box CLEAN OUT

A - 50' 7"

B - 45' 2"

## LABOR AND MATERIALS

1	Copper Lead	}	Connection	$\frac{3}{4}$ "		\$
1	Curb	}	Cock Valve T.S. & V.	$\frac{3}{4}$ in.	(MAY 12 BY 15241)	\$
1	Service box Old returned	}	Short $3\frac{1}{2}$ x $4\frac{1}{2}$ Long $4\frac{1}{2}$ x $5\frac{1}{2}$ Buff or Rdway			\$
26	$\frac{3}{4}$		Ft. in.	}	Copper C.I. C.I.	} Pipe at \$
	Nipples		in.			\$
	Bushings		to		in.	at \$
	Red'g Inc'g		Coupl'gs.		to	in. at \$
	Union		in.			at \$
	Meter		in.			at \$
	Lead Joints					at \$
	Compound Joints					at \$
	Maintenance Foreman					\$
	Hrs. Water Maint. Man-1				at	\$
	Hrs. Water Maint. Man-2				at	\$
	Hrs. Garage Foreman				at	\$
	Hrs. Labor				at	\$
	Hrs. Compressor				at	\$
	Compensation Ins.		at \$		per C	\$
	Trucking					\$
	Pav't Patch					\$
	<i>Tap made by Gifford Co</i>					\$
	<i>AUG-6-1974</i>					\$
	O'head					\$
						\$