

LABOR AND MATERIALS

Copper	} Connection _____	in.	\$ _____
Lead			
Curb	} Cock Valve T. S. & V. _____	in.	\$ _____
Service box			
Old returned	} Short $3\frac{1}{2} \times 4\frac{1}{2}$ Long $4\frac{1}{2} \times 5\frac{1}{2}$ _____		\$ _____
Ft. $3/4$ in.	} Copper G. I. C. I. _____	Pipe at	\$ _____
Nipples	in. at		\$ _____
Bushings	to _____ in.	at	\$ _____
Red'g Inc'g	} Coupl'gs _____ to _____ in.	at	\$ _____
Union			
Meter	in. at		\$ _____
			\$ _____
			\$ _____
Compound Joints	at		\$ _____
Maintenance Foreman			\$ _____
Hrs. Water Maint. Man-1	at		\$ _____
Hrs. Water Maint. Man-2	at		\$ _____
Hrs. Garage Foreman	at		\$ _____
Hrs. Labor	at		\$ _____
Hrs. Compressor	at		\$ _____
			\$ _____
Trucking			\$ _____
Pav't Patch			\$ _____
			\$ _____
			\$ _____
			\$ _____
			\$ _____

WOODARD


St. _____
Pl. _____
Ave. No. 8

Name of Owner _____

TAX ID # 309.16-5-8

Labor and Mat'l. Report _____

19

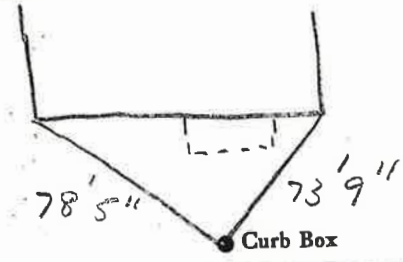

6 Main

Elev. of Main at tap 4 1/2'

Gate at ●

● Gate at

10' to MAIN

● Curb Box

