

### LABOR AND MATERIALS

Copper	} Connection _____	\$ _____	
Lead			
Curb	} Cock _____	\$ _____	
			} Valve _____
Service box	} Short 3½ x 4½ _____	\$ _____	
			} Long 4½ x 5½ _____
Old returned			
Ft. _____ in.	} Copper _____	\$ _____	
			} G. I. _____
	} Pipe at _____		
Nipples _____ in.		\$ _____	
Bushings _____ to _____ in.		\$ _____	
Red'g } Coupl'gs _____ to _____ in.		\$ _____	
Inc'g }			
Union _____ in.		\$ _____	
Meter _____ in.		\$ _____	
Lead Joints at _____		\$ _____	
Compound Joints at _____		\$ _____	
Maintenance Foreman _____		\$ _____	
Hrs. Water Maint. Man-1 at _____		\$ _____	
Hrs. Water Maint. Man-2 at _____		\$ _____	
Hrs. Garage Foreman _____ at _____		\$ _____	
Hrs. Labor _____ at _____		\$ _____	
Hrs. Compressor at _____		\$ _____	
Compensation Ins. at \$ _____ per C		\$ _____	
Trucking _____		\$ _____	
Pav't Patch _____		\$ _____	
_____		\$ _____	
_____		\$ _____	
O'head _____		\$ _____	


Woodard

St. ~~12~~  
Ave. No. 15

Name of Owner

Charlotte Jordan

Labor and Mat'l. Report July 15 1922

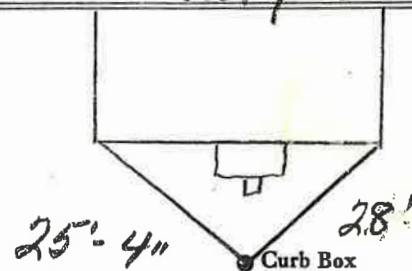

6" Main

Elev. of  
Main at tap

Gate at ●

● Gate at

TAX ID # 309.15-9-17

● Curb Box