


LABOR AND MATERIALS

Copper Lead	Connection		\$		
Curb	{ Clock Valve T. S. & V. }	}	in.	\$	
Service box Old returned	{ Short 3 1/2 X 4 1/2 Long 4 1/2 X 5 1/2 Buff or Rdway }	}		\$	
Ft.	in.	{ Copper Galv. Iron Cast Iron }	Pipe at	\$	
Nipples	in.	at		\$	
Bushings	to	in.	at	\$	
Red'g Inc'g	{ Couplings	} to	in.	at	
Union					in.
Meter	in.	at		\$	
Lead Joints	at			\$	
Compound Joints	at			\$	
Hrs. Foreman	at			\$	
Hrs. Chauffeur	at			\$	
Hrs. Tapper	at			\$	
Hrs. Labor	at			\$	
Hrs. Labor	at			\$	
Hrs. Compressor	at			\$	
Compensation Ins.				\$	
Trucking				\$	
Builders Use of Water				\$	
<i>Warsinski & Son</i>				\$	
				\$	
				\$	
St. Woodard
Pl. 17
Ave. No. 17

Name of Owner
TAX ID # 309.15-9-16

Labor and Mat'l. Report 194

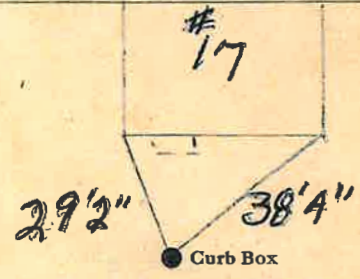

Main Elev. of
Main at tap

Gate at ● ● Gate at

● Curb Box