


LABOR AND MATERIALS

1 Copper } Connection 3/4" \$ \_\_\_\_\_  
 Lead }  
 1 Curb } Cock } 3/4 in. \$ \_\_\_\_\_  
 } Valve }  
 } T. S. & V. }  
 1 Service box } Short 3 1/2 x 4 1/2 }  
 Old returned } Long 4 1/2 x 5 1/2 } \$ \_\_\_\_\_  
 } Buff or Rdway }  
 12 Ft. 3/4 in. } Copper } Pipe at \$ \_\_\_\_\_  
 } C. I. }  
 } C. I. }  
 Nipples \_\_\_\_\_ in. at \$ \_\_\_\_\_  
 Bushings \_\_\_\_\_ to \_\_\_\_\_ in. at \$ \_\_\_\_\_  
 Red'g } Coupl'gs. \_\_\_\_\_ to \_\_\_\_\_ in. at \$ \_\_\_\_\_  
 Inc'g }  
 Union \_\_\_\_\_ in. at \$ \_\_\_\_\_  
 Meter \_\_\_\_\_ in. at \$ \_\_\_\_\_  
 Lead Joints at \$ \_\_\_\_\_  
 Compound Joints at \$ \_\_\_\_\_  
 Maintenance Foreman \$ \_\_\_\_\_  
 Hrs. Water Maint. Man-1 at \$ \_\_\_\_\_  
 Hrs. Water Maint. Man-2 at \$ \_\_\_\_\_  
 Hrs. Garage Foreman \_\_\_\_\_ at \$ \_\_\_\_\_  
 Hrs. Labor \_\_\_\_\_ at \$ \_\_\_\_\_  
 Hrs. Compressor at \$ \_\_\_\_\_  
 Compensation Ins. at \$ \_\_\_\_\_ per C \$ \_\_\_\_\_  
 Trucking \$ \_\_\_\_\_  
 Pay't Patch \$ \_\_\_\_\_  
Tap by Giggord & Co.  
7-31-64.  
 O'head \$ \_\_\_\_\_

St. Woodard No. 18  
 Pt. Ave.  
 Name of Owner Corner Taylor St.  
Albert Freyone  
 Labor and Mat'l. Report July 31 1964.

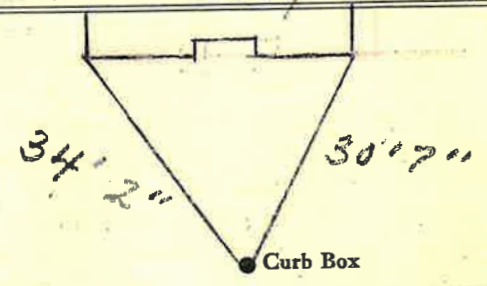

6 C.I. Main Elev. of Main at tap 4'  
 Gate at • Gate at  
12' to main

• Curb Box  
Tap on Woodard St.

TAX ID # 309-16-5-12