


Labor and Materials

Copper } Connection.....		\$ 3.20
Lead }		
Curb } Cock }		\$ 1.00
} Valve }		
} T. S. & V. }		
Service Box } Short 3 1/2 x 4 1/2 }		\$ 1.40
Old returned } Long 4 1/2 x 5 1/2 }		
} Buff. or Rdway }		
Ft. in. } Copper } Pipe at.....		\$ 1.98
} Galv. Iron }		
} Cast Iron }		
Nipples..... in. at.....		\$
Bushings..... to..... in. at.....		\$.07
Red'g } Couplings..... to..... in. at.....		\$
Inc'g }		
Union..... in. at.....		\$
Meter..... in. at.....		\$
Lbs. Br. Stone at.....		\$
Lbs. Sand at.....		\$
Bags Cement at.....		\$
Paving Brick } Mack } at.....		\$
} Red }		
} Asphalt }		
Lead Joints at.....		\$
Leadite Joints at.....		\$
4 Hrs. Foreman at.....	62.5-	\$ 2.50
Hrs. Common Labor at.....		\$
11 Hrs. Common Labor at.....	40%	\$ 4.40
Hrs. Mason at.....		\$
Hrs. Mason's Helper at.....		\$
Hrs. Compressor at.....		\$
Compensation Ins.....		\$.18
Trucking.....		\$ 1.00
Builders' Use of Water.....		\$
Total		\$ 15.79

27-38 10

Labor and Material Report May 6 1927

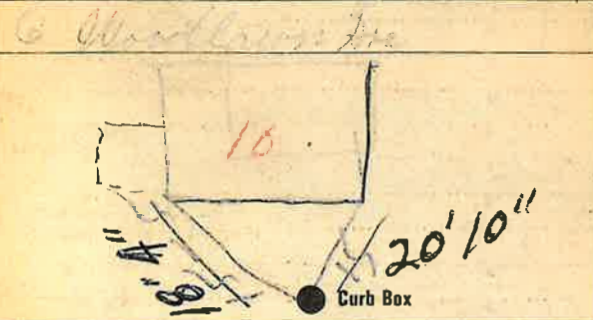

4" Main Elev. of Main at tap 5'
 Gate at ● 9' to main Gate at ●

● Curb Box
Old tap shut off

TAX ID# 309.12-11-22