

**Labor and Materials**

1	Copper	Connection	\$ 3.20
1	Curb	{ Cock Valve T. S. & V. } in.	\$ 1.00
1	Service Box	{ Short 3 1/2 x 4 1/2 Long 4 1/2 x 5 1/2 Buff. or Rdway }	\$ 1.30
22	Ft.	in. { Copper Galv. Iron } Pipe at	\$ 4.84
	Nipples	in. at	\$
	Bushings	to in. at	\$
	Red'g Inc'g	Couplings to in. at	\$
	Union	in. at	\$
	Meter	in. at	\$
	Lbs. Br. Stone	at	\$
	Lbs. Sand	at	\$
	Bags Cement	at	\$
	Paving Brick	{ Mack Red Asphalt } at	\$
	Lead Joints	at	\$
	Leadite Joints	at	\$
4	Hrs. Foreman	at	\$ 2.50
18	Hrs. Common Labor	at	\$ 7.31
	Hrs. Common Labor	at	\$
	Hrs. Mason	at	\$
	Hrs. Mason's Helper	at	\$
	Hrs. Compressor	at	\$
	Compensation Ins.	at	\$ 2.6
	Trucking	at	\$ 10.0
	Builders' Use of Water	at	\$
Total			\$ 21.41


2-28

11

**Labor and Material Report**

15 1927

Woodlawn Ave

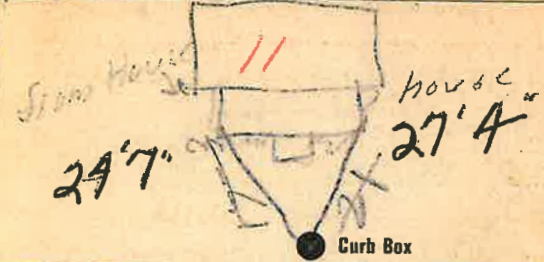

Main Elev. of Main at tap 25  
Gate at ● 22' to MAIN ● Gate at

● Curb Box

old Tap  
shut off

Woodlawn Ave

TAX ID # 30\*.12-11-30