

LABOR AND MATERIALS


1	Copper	{	Connection	3/4"	\$	304
1	Lead	{	Cock Valve	3/4" in.	\$	354
			T. S. & V.			
1	Service box	{	Short	3 1/2 x 4 1/2		
	Old returned	{	Long	4 1/2 x 5 1/2	\$	470
			Buff or Rdway			
23	Ft.	in.	Copper	Pipe at 35	\$	8.05
			G.I.			
	Nipples	in. at			\$	
	Bushings	to in. at			\$	
	Red'g	{	Coupl'gs	to in. at	\$	
	Inc'g					
	Union	in. at			\$	
	Meter	in. at			\$	
	Lead Joints	at			\$	
	Compound Joints	at			\$	
3	Hrs. Water Maint. Man-1	at	1.23	\$	369.0	
11	Hrs. Water Maint. Man-2	at	1.13	\$	1243.0	
9	Hrs. Labor	at	1.02	\$	918.0	
	Hrs. Labor	at		\$		
1	Hrs. Compressor	at		\$	150	
	Compensation Ins. at \$2.66	per C.		\$	67	
	Trucking			\$	1.00	
	Pav't Patch			\$	12.15	
				\$		
				\$		
	O'head			\$		
				\$	59.95	

Tap made by Warsinski
June 14, 1951

13 Woodlawn St.
Pt. Ave. No. 13

Name of Owner
Lamoureaux

Labor and Mat'l. Report June 14 1951

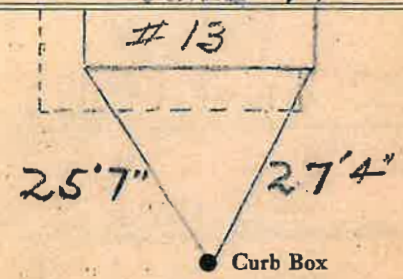

4" Main Elev. of Main at tap 4'

Gate at ● Gate at ●

23' to main

● Curb Box

Old Tap Disconnected

TAX ID # 309.12-11-29