LABOR AND MATERIALS

1 ~~Copper~~ ~~Lead~~ Connection 3/4 $

1 Curb Cock / Valve / T. S. & V. 3/4 in. (orisenal) $

1 Service box Old returned ~~Short 3½ x 4½~~ Long 4½ x 5½ ~~Buff or Redway~~ $

14 Ft. 3/4 in. ~~Copper~~ ~~C. I.~~ ~~G. I.~~ Pipe at $

Nipples in. at $

Bushings to in. at $

Red'g / Inc'g Coupl'gs to in. at $

Union in. at $

Meter in. at $

Lead Joints at $

Compound Joints at $

Maintenance Foreman $

Hrs. Water Maint. Man—1 at $

Hrs. Water Maint. Man—2 at $

Hrs. Garage Foreman at $

Hrs. Labor— at $

Hrs. Compressor at $

Compensation Ins. at $ per C $

Trucking $

Pav't Patch $

Tap Made By Beecher & Co $

$

O'head June-30-1975 $

$

St. Pl. Ave. No. ?

Arlington Acres

Name of Owner

Eva Harvey Estate

Labor and Mat'l. Report June 30 1975

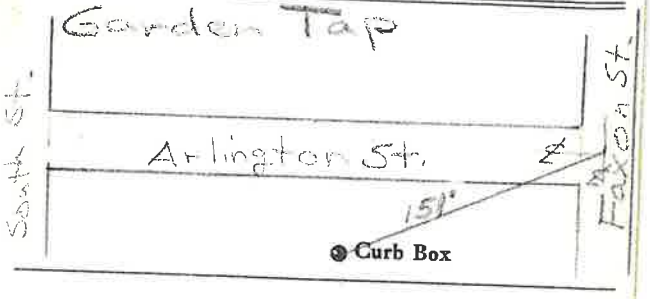

8" Main

Elev. of Main at tap 5'

Gate at ●

● Gate at

● Curb Box

LSM—5C—6-1-67