LABOR AND MATERIALS

Copper / Lead } Connection ____ $____

Curb { Cock / Valve / T. S. & V. } ____ in. ____ $____

Service box / Old returned { Short 3½ x 4½ / Long 4½ x 5½ } ____ $____

51' 3/4 Ft. ____ in. { Copper / ~~G. I.~~ / C. I. } Pipe at ____ $____

____ Nipples ____ in. at ____ $____

____ Bushings ____ to ____ in. at ____ $____

Red'g / Inc'g } Coupl'gs ____ to ____ in. at ____ $____

____ Union ____ in. at ____ $____

____ Meter ____ in. at ____ $____

____ ____ $____

____ Compound Joints at ____ $____

____ Maintenance Foreman ____ $____

____ Hrs. Water Maint. Man—1 at ____ $____

____ Hrs. Water Maint. Man—2 at ____ $____

____ Hrs. Garage Foreman ____ at ____ $____

____ Hrs. Labor— ____ at ____ $____

____ Hrs. Compressor at ____ $____

____ $____

____ Trucking ____ $____

____ Pav't Patch ____ $____

____ $____

____ $____

____ $____

____ $____

$____

20 Arlington St. / ~~Pl.~~ / ~~Ave.~~ No. 20

Name of Owner

Labor and Mat'l. Report 1987

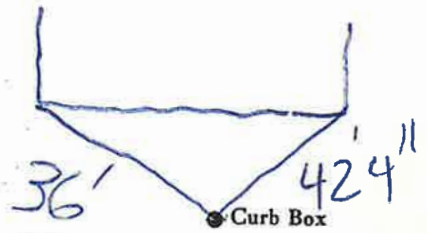

8" Main

Elev. of Main at tap ____

Gate at ●

● Gate at

● Curb Box

LSM—5C—6-1-67

Tax ID #309.16-3-22