LABOR AND MATERIALS

1 Copper ~~Lead~~ Connection 3/4 $

1 Curb ~~Cock~~ ~~Valve~~ ~~T. S. & V.~~ in. 3/4 $

1 Service box Old returned ~~Short 3½ x 4½~~ Long 4½ x 5½ ~~Buff or Rdway~~ $

32 Ft. 3/4 in. ~~Copper~~ ~~C. I.~~ ~~C. I.~~ Pipe at $

Nipples in. at $

Bushings to in. at $

Red'g Inc'g Coupl'gs to in. at $

Union in. at $

Meter in. at $

Lead Joints at $

Compound Joints at $

Maintenance Foreman $

Hrs. Water Maint. Man—1 at $

Hrs. Water Maint. Man—2 at $

Hrs. Garage Foreman at $

Hrs. Labor— at $

Hrs. Compressor at $

Compensation Ins. at $ per C $

Trucking $

Pav't Patch $

$

$

$

O'head $

$

BAY St. Pl. Ave. No. 172

Name of Owner

Labor and Mat'l. Report 19

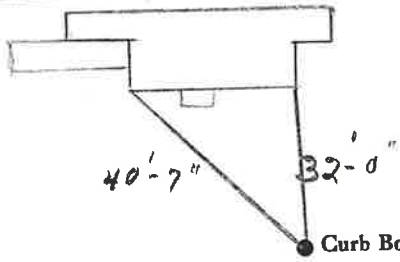

1 Main Elev. of Main at tap 5 1/2

Gate at • • Gate at

• Curb Box

LSM—5C—6-1-67