## LABOR-AND-MATERIALS

1 Copper / ~~Lead~~ } Connection 3/4 $

1 Curb { Cock / ~~Valve~~ / ~~T. S. & V.~~ } 3/4 in. $

1 Service box { ~~Short 3½ x 4½~~ / Long 4½ x 5½ / ~~Buff or Rdway~~ } Old returned $

9 Ft. 3/4 in. { Copper / ~~G. I.~~ / ~~C. I.~~ } Pipe at $

Nipples in. at $

Bushings to in. at $

{ Red'g / Inc'g } Coupl'gs to in. at $

Union in. at $

Meter in. at $

Lead Joints at $

Compound Joints at $

Maintenance Foreman $

Hrs. Water Maint. Man—1 at $

Hrs. Water Maint. Man—2 at $

Hrs. Garage Foreman at $

Hrs. Labor— at $

Hrs. Compressor at $

Compensation Ins. at $ per C $

Trucking $

Pav't Patch $

$

$

$

O'head $

$

BAY St. / ~~Pl.~~ / ~~Ave.~~ No. 73

Name of Owner

Labor and Mat'l. Report 19

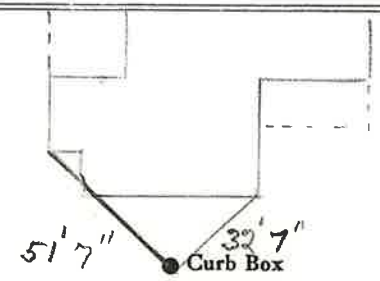


10 Main Elev. of Main at tap 5

Gate at ● ● Gate at

● Curb Box

LSM—5C—6-1-67