LABOR AND MATERIALS

1 ~~Copper~~ / ~~Lead~~ } Connection 3/4" $

1 Curb { Cock / ~~Valve~~ / ~~T. S. & V.~~ } 3/4 in. $

1 Service box / Old returned { Short 3½ x 4½ / ~~Long 4½ x 5½~~ / ~~Buff or Rdway~~ } $

12 Ft. 3/4 in. { Copper / ~~C. I.~~ / ~~C. I.~~ } Pipe at $

Nipples in. at $

Bushings to in. at $

Red'g / Inc'g } Coupl'gs to in. at $

Union in. at $

Meter in. at $

Lead Joints at $

Compound Joints at $

Maintenance Foreman $

Hrs. Water Maint. Man—1 at $

Hrs. Water Maint. Man—2 at $

Hrs. Garage Foreman at $

Hrs. Labor— at $

Hrs. Compressor at $

Compensation Ins. at $ per C $

Trucking $

Pav't Patch $

$

$

$

O'head $

$

BAY ST St. / ~~Pl.~~ / ~~Ave.~~ No. 143

Name of Owner

TAX ID # 302.16-15-23

Labor and Mat'l. Report 19

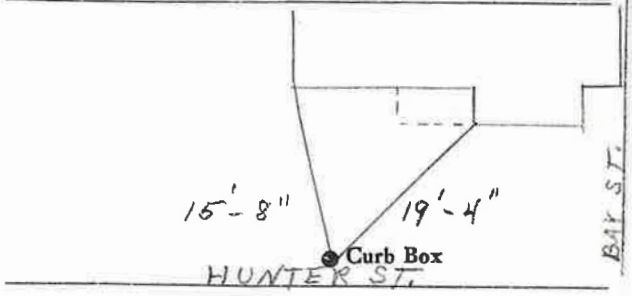

1" Main

Elev. of Main at tap 5'

Gate at •

• Gate at

• Curb Box

LSM—5C—6-1-67